ANNEXURE D

AS CONSTRUCTED

USE BLACK INK OR BLACK BALL POINT PEN ONLY

WATER CORPORATION

PLEASE PRINT CLEARLY				LICENSED PLUMBERS NAME	FOR OFFICE USE ONLY	
Lot No.	5	Strata Lot No	1 – 6	Craig Webster	F/B Folio / Page	
House No 144	Street BICKLEY ROAD				Sewer District	
Town / Suburb BECKENHAM.				Licence Number PL7805	Account No	
Owners Name				PLB Notice of Intention	File / WAPC. Ref	

Show distance from down stream A/C, M/S or I.S. intersection (if none available provide location sketch from property boundary).		Provide a brought **IN** measurement from the sewer main centre line to the connection end point within the property.		Provide a brought **UP** measurement from the invert of the sewer main to the connection end point within the property.	

I CERTIFY THAT THIS PLAN SHOWS THE LAYOUT AND DIMENSIONS OF THE PROPERTY SEWER CONSTRUCTED BY ME OR UNDER MY SUPERVISION AT THE ABOVE ADDRESS SHOWN.

LICENCED PLUMBER'S SIGNATURE _____ **DATE** 15 / 10 / 2015

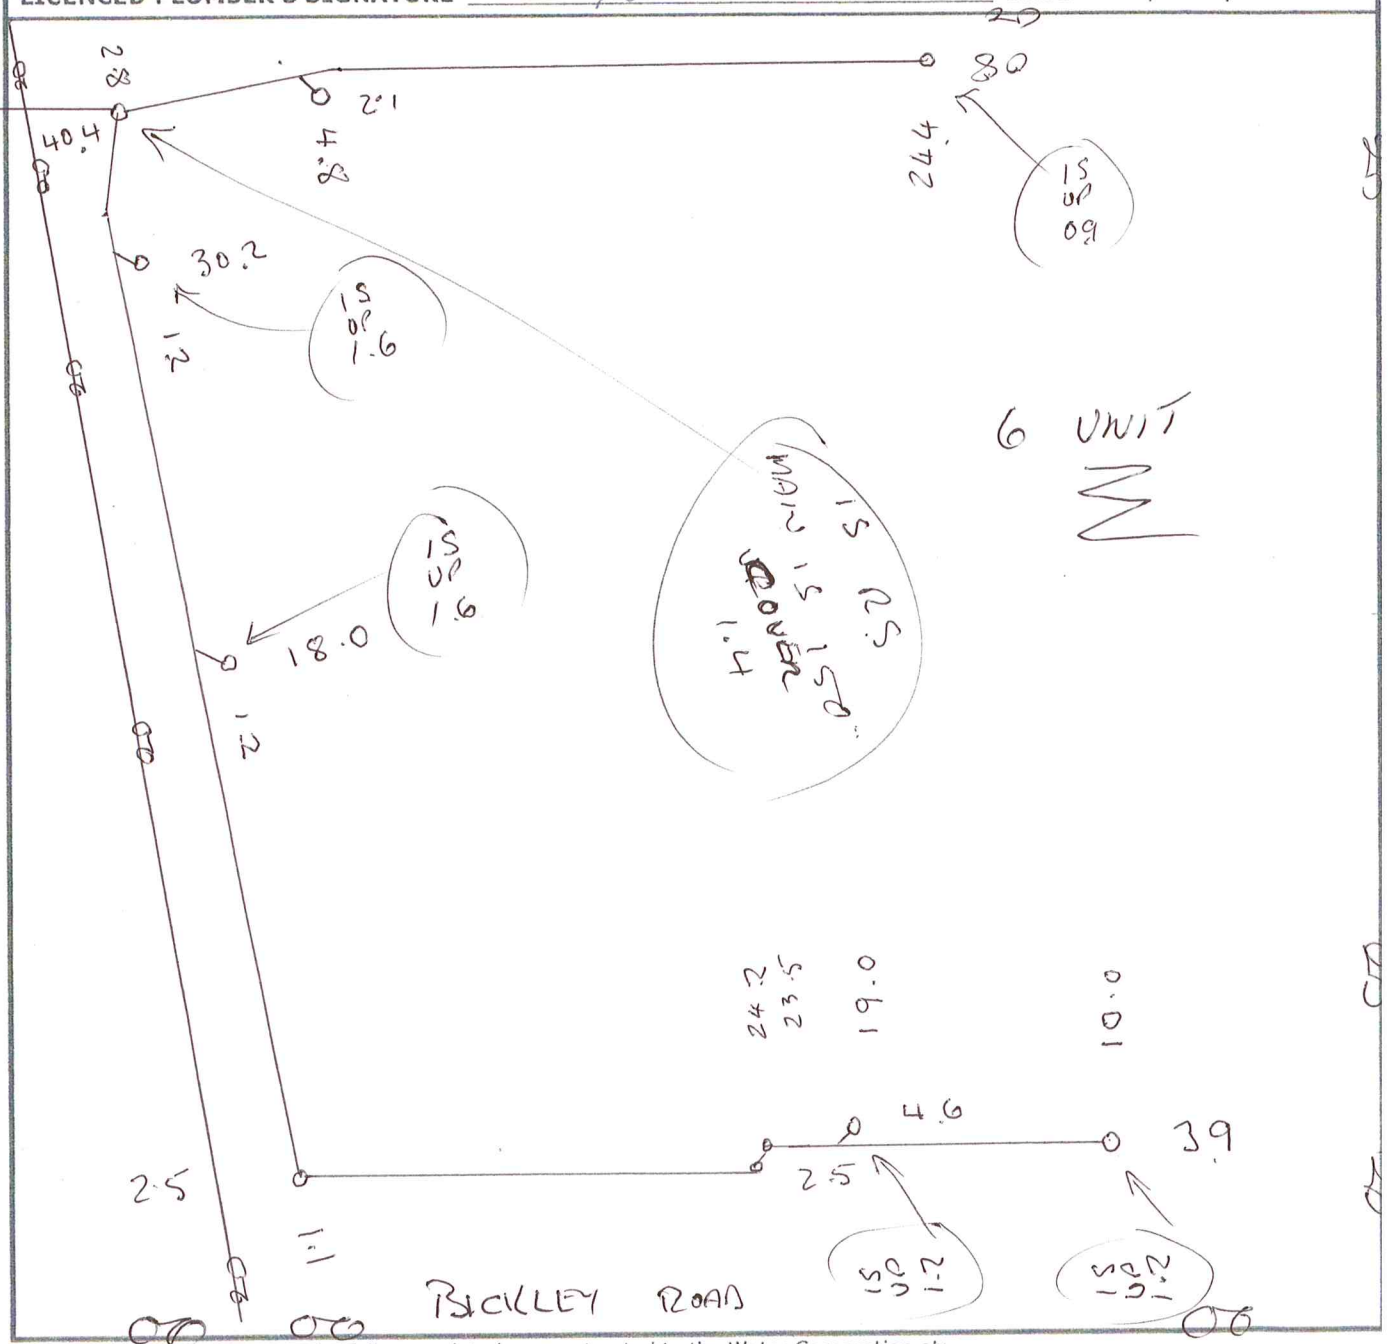

Please return the fully completed as constructed to the Water Corporation at;
POST Development Services Branch, Water Corporation, PO Box PO Box 100 Leederville WA 6902
EMAIL building.services@watercorporation.com.au